

NUMBERS, UNIT LOCATION, APPROXIMATE DIMENSIONS AND MAIN ENTRANCES AND THE PUBLIC WAY TO WHICH THE UNITS HAVE ACCESS, AS-BUILT AS OF NOVEMBER 29, 2006, I ALSO CERTIFY THAT THE PLAN WAS PREPARED IN ACCORDANCE WITH THE RULES AND REGULATIONS OF THE REGISTRY OF DEEDS.

UNIT 204 :1100 S.F. TOTAL UNIT 205 :1093 S.F. TOTAL UNIT 206 : 2346 S.F. TOTAL UNIT 301 : 2243 S.F. TOTAL


UNIT 302 :1895 S.F. TOTAL

UNIT PH 2 : 2083 S.F. TOTAL UNIT PH 3 : 1957 S.F. TOTAL UNIT PH 4 : 2329 S.F. TOTAL UNIT PH 5 : 1884 S.F. TOTAL UNIT PH 6 : 1730 S.F. TOTAL

Unit Entrance: Exterior Limited Common Element Area:

CAMBRIDGE, MA 02141 (617)250-6800

GUNDPARTNERSHIP

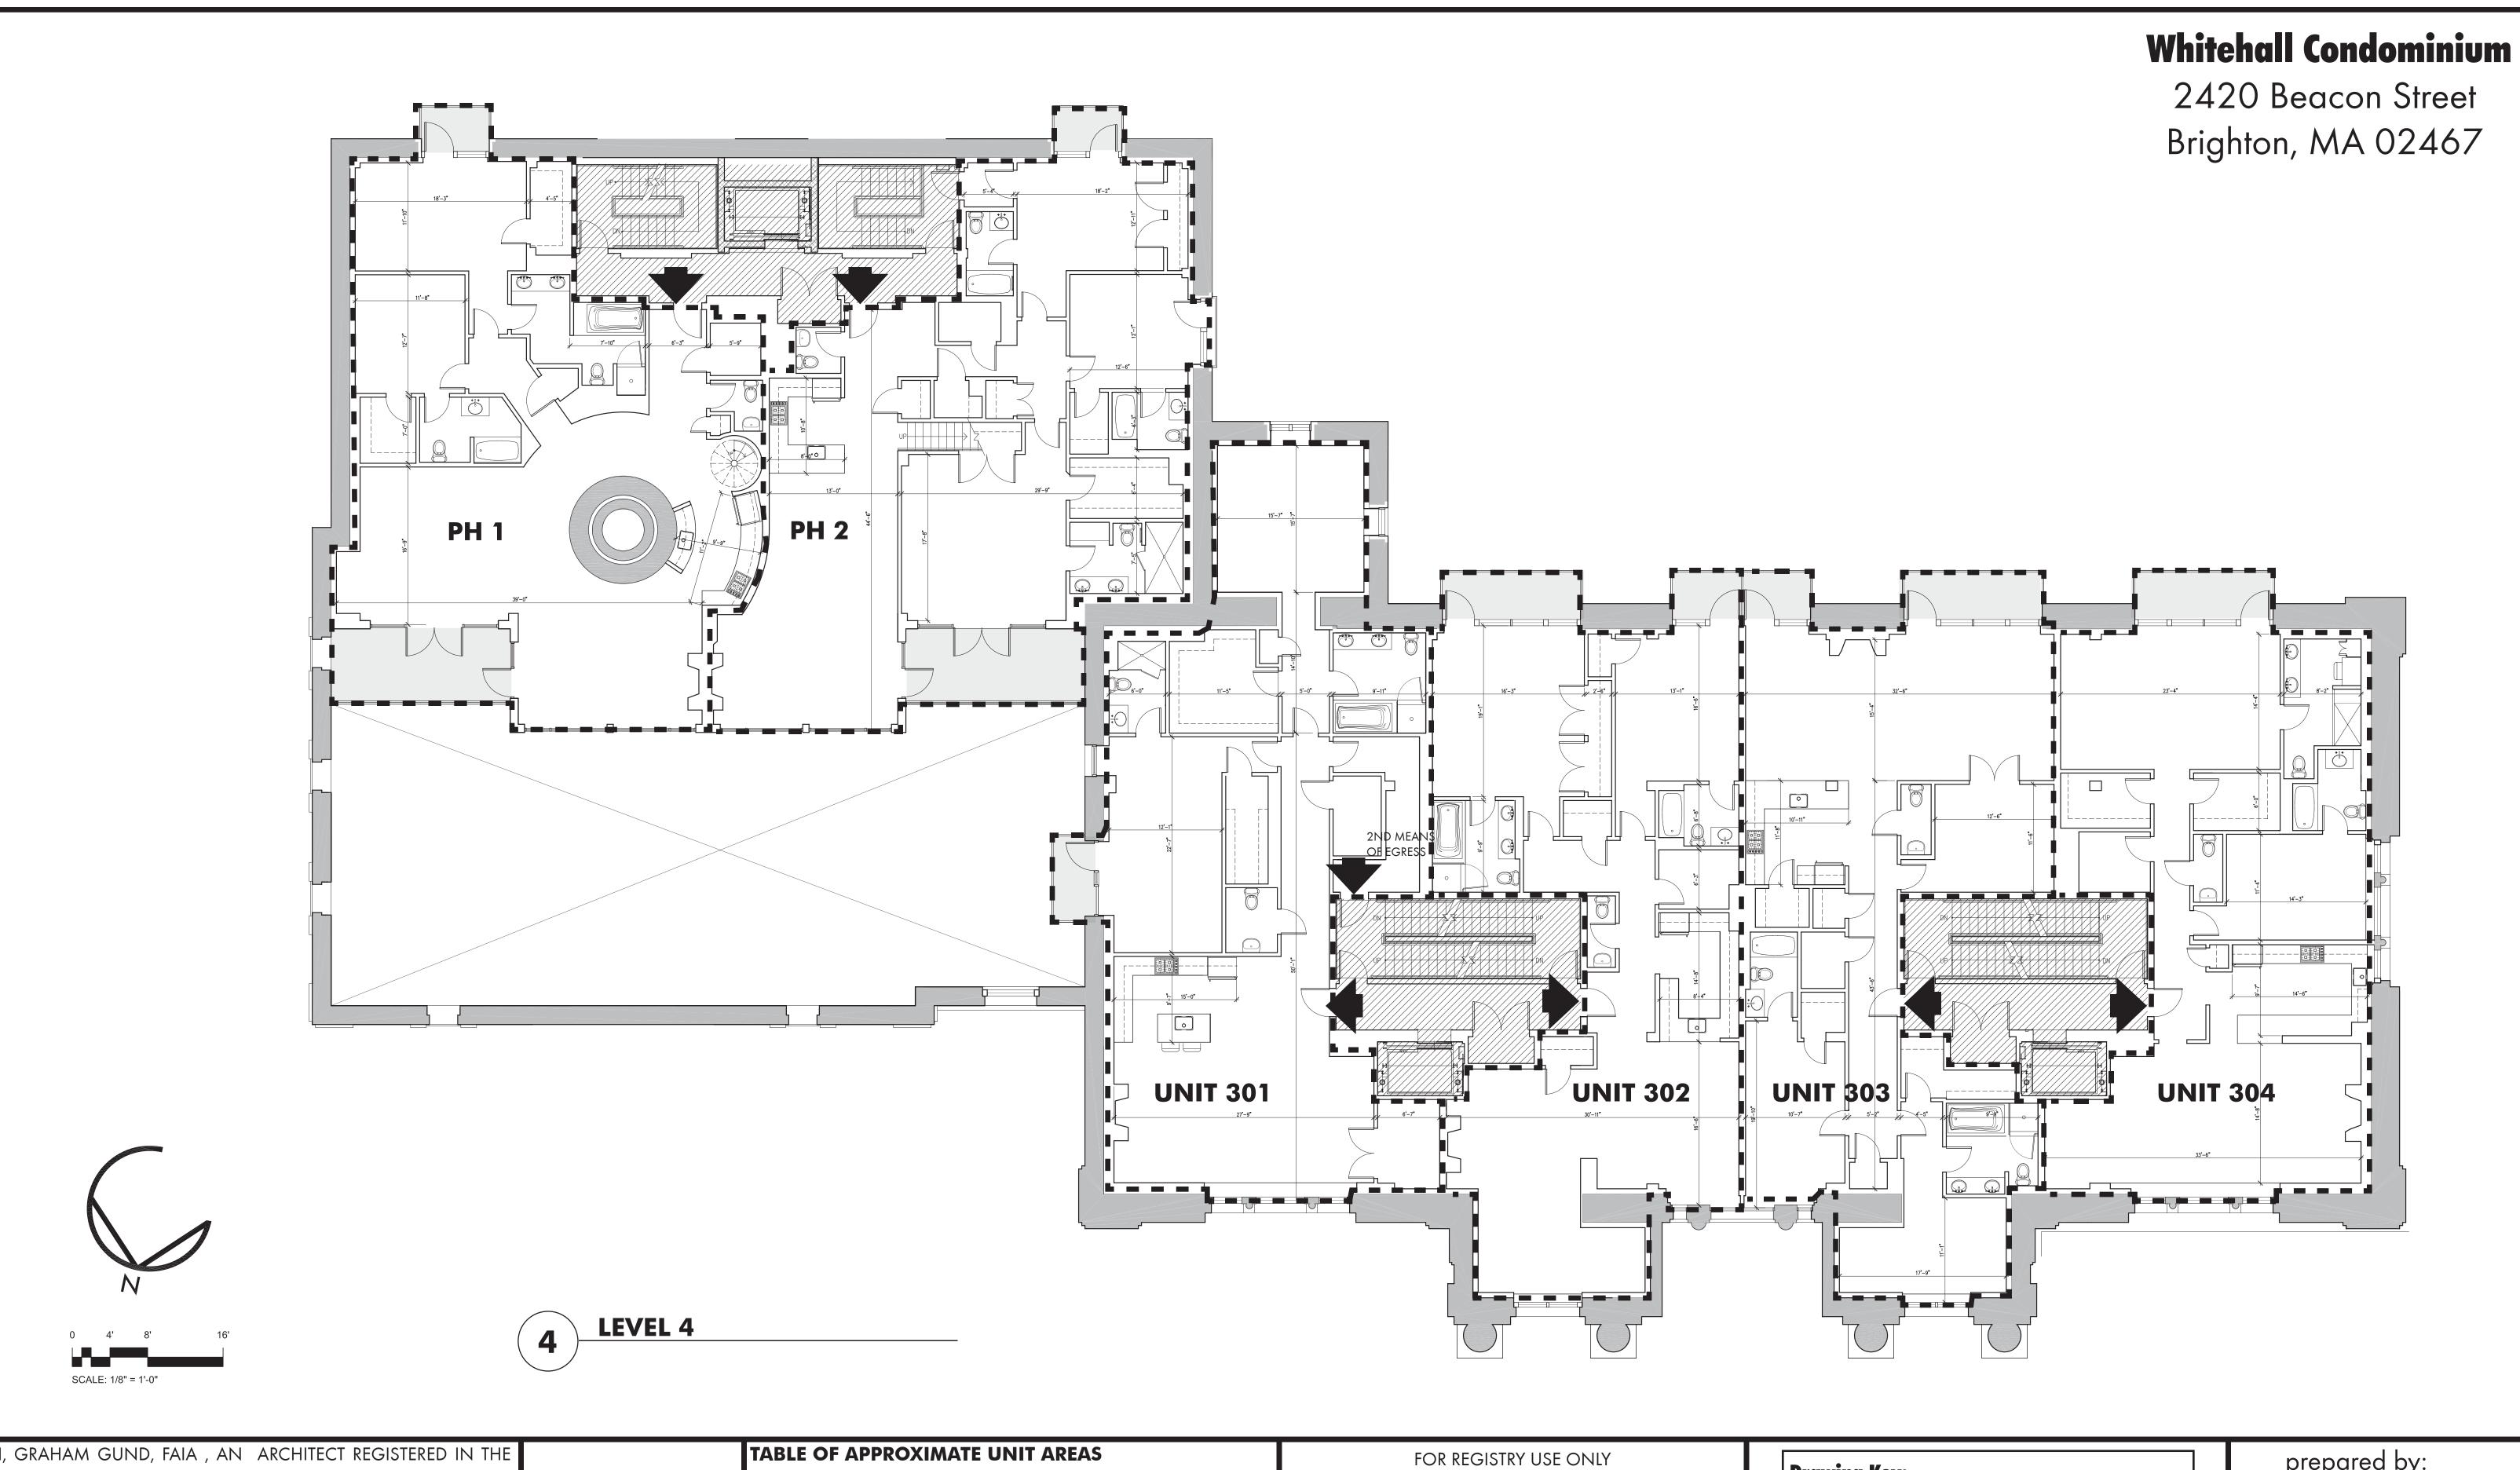

COMMONWEALTH OF MASSACHUSETTS, DO HERBY CERTIFY THAT THIS MASTER PLAN SHEET SHOWING THE WHITEHALL BUILDING IN THE CITY OF BRIGHTON , SUFFOLK COUNTY, MASSACHUSETTS, DEPICTS THE LAYOUT OF THE BUILDING AND THE UNITS, UNIT NUMBERS, UNIT LOCATION, APPROXIMATE DIMENSIONS AND MAIN ENTRANCES AND THE PUBLIC WAY TO WHICH THE UNITS HAVE ACCESS, AS-BUILT AS OF NOVEMBER 29, 2006, I ALSO CERTIFY THAT THE PLAN WAS PREPARED IN ACCORDANCE WITH THE RULES AND REGULATIONS OF THE REGISTRY OF DEEDS.

Graham Gund, FAIA Registered Architect # 3720


GUNDPARTNERSHIP

UNIT 101 : 2010 S.F. TOTAL UNIT 303 :1883 S.F. TOTAL UNIT 102 :1883 S.F. TOTAL UNIT 304:1831 S.F. TOTAL UNIT 201 : 2044 S.F. TOTAL UNIT 401 :1895 S.F. TOTAL UNIT 202 : 2118 S.F. TOTAL UNIT 402 :1900 S.F. TOTAL UNIT 203 : 2647 S.F. TOTAL UNIT PH 1 : 2094 S.F. TOTAL UNIT 204 :1100 S.F. TOTAL UNIT PH 2 : 2083 S.F. TOTAL UNIT 205 :1093 S.F. TOTAL UNIT PH 3 :1957 S.F. TOTAL UNIT 206 : 2346 S.F. TOTAL UNIT PH 4 : 2329 S.F. TOTAL UNIT PH 5 :1884 S.F. TOTAL UNIT 301 : 2243 S.F. TOTAL UNIT 302 :1895 S.F. TOTAL UNIT PH 6 :1730 S.F. TOTAL

Drawing Key: Line of Limit of Ownership: Common Area: Unit Entrance: Exterior Limited Common Element Area:

prepared by:

GUND PARTNERSHIP 47 THORNDIKE STREET CAMBRIDGE, MA 02141 (617)250-6800 GUNDPARTNERSHIP

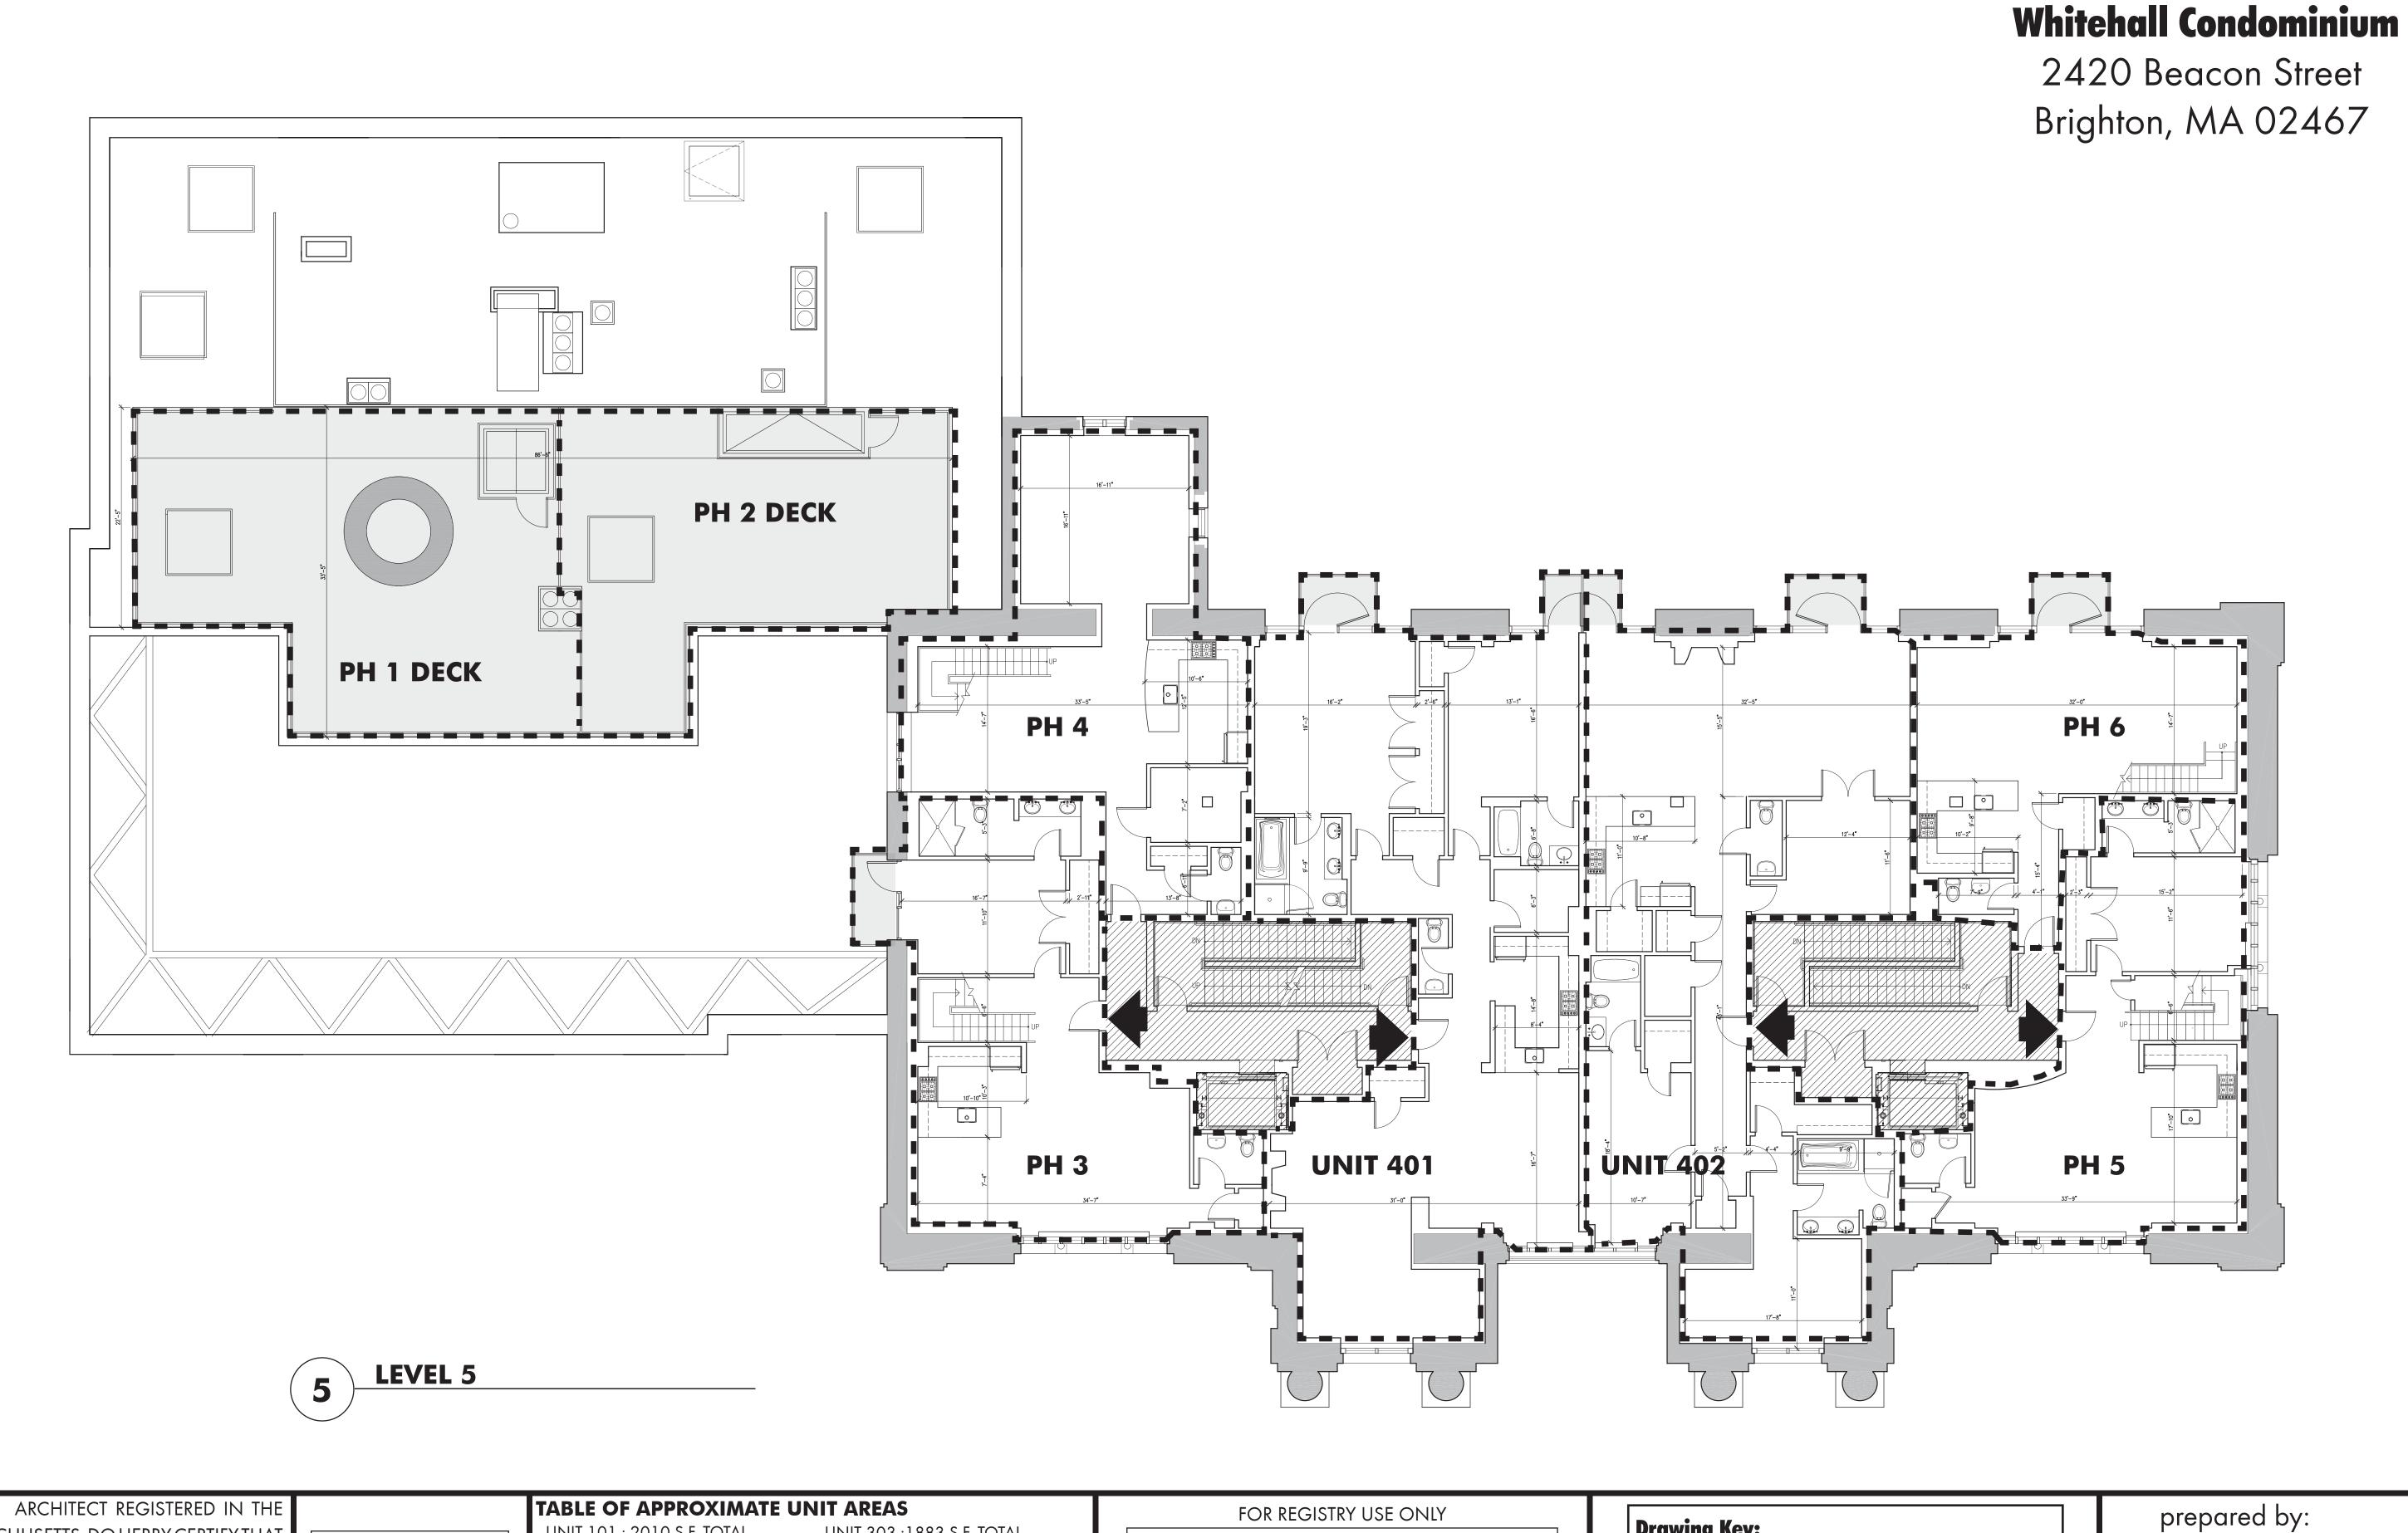

, GRAHAM GUND, FAIA , AN ARCHITECT REGISTERED IN THE COMMONWEALTH OF MASSACHUSETTS, DO HERBY CERTIFY THAT THIS MASTER PLAN SHEET SHOWING THE WHITEHALL BUILDING IN THE CITY OF BRIGHTON , SUFFOLK COUNTY, MASSACHUSETTS, DEPICTS THE LAYOUT OF THE BUILDING AND THE UNITS, UNIT NUMBERS, UNIT LOCATION, APPROXIMATE DIMENSIONS AND MAIN ENTRANCES AND THE PUBLIC WAY TO WHICH THE UNITS HAVE ACCESS, AS-BUILT AS OF NOVEMBER 29, 2006, I ALSO CERTIFY THAT THE PLAN WAS PREPARED IN ACCORDANCE WITH THE RULES AND REGULATIONS OF THE REGISTRY OF DEEDS.

SCALE: 1/8" = 1'-0"

GUNDPARTNERSHIP Graham Gund, FAIA Registered Architect # 3720


UNIT 101 : 2010 S.F. TOTAL UNIT 303 :1883 S.F. TOTAL UNIT 102 :1883 S.F. TOTAL UNIT 304 :1831 S.F. TOTAL UNIT 201 : 2044 S.F. TOTAL UNIT 401 :1895 S.F. TOTAL UNIT 202 : 2118 S.F. TOTAL UNIT 402 :1900 S.F. TOTAL UNIT 203 : 2647 S.F. TOTAL UNIT PH 1 : 2094 S.F. TOTAL UNIT 204 :1100 S.F. TOTAL UNIT PH 2 : 2083 S.F. TOTAL UNIT 205 :1093 S.F. TOTAL UNIT PH 3 :1957 S.F. TOTAL UNIT 206 : 2346 S.F. TOTAL UNIT PH 4 : 2329 S.F. TOTAL UNIT 301 : 2243 S.F. TOTAL UNIT PH 5 : 1884 S.F. TOTAL UNIT 302 :1895 S.F. TOTAL UNIT PH 6 : 1730 S.F. TOTAL

Drawing Key: Line of Limit of Ownership: Common Area: Unit Entrance: Exterior Limited Common Element Area:

GUND PARTNERSHIP

47 THORNDIKE STREET CAMBRIDGE, MA 02141 (617)250-6800



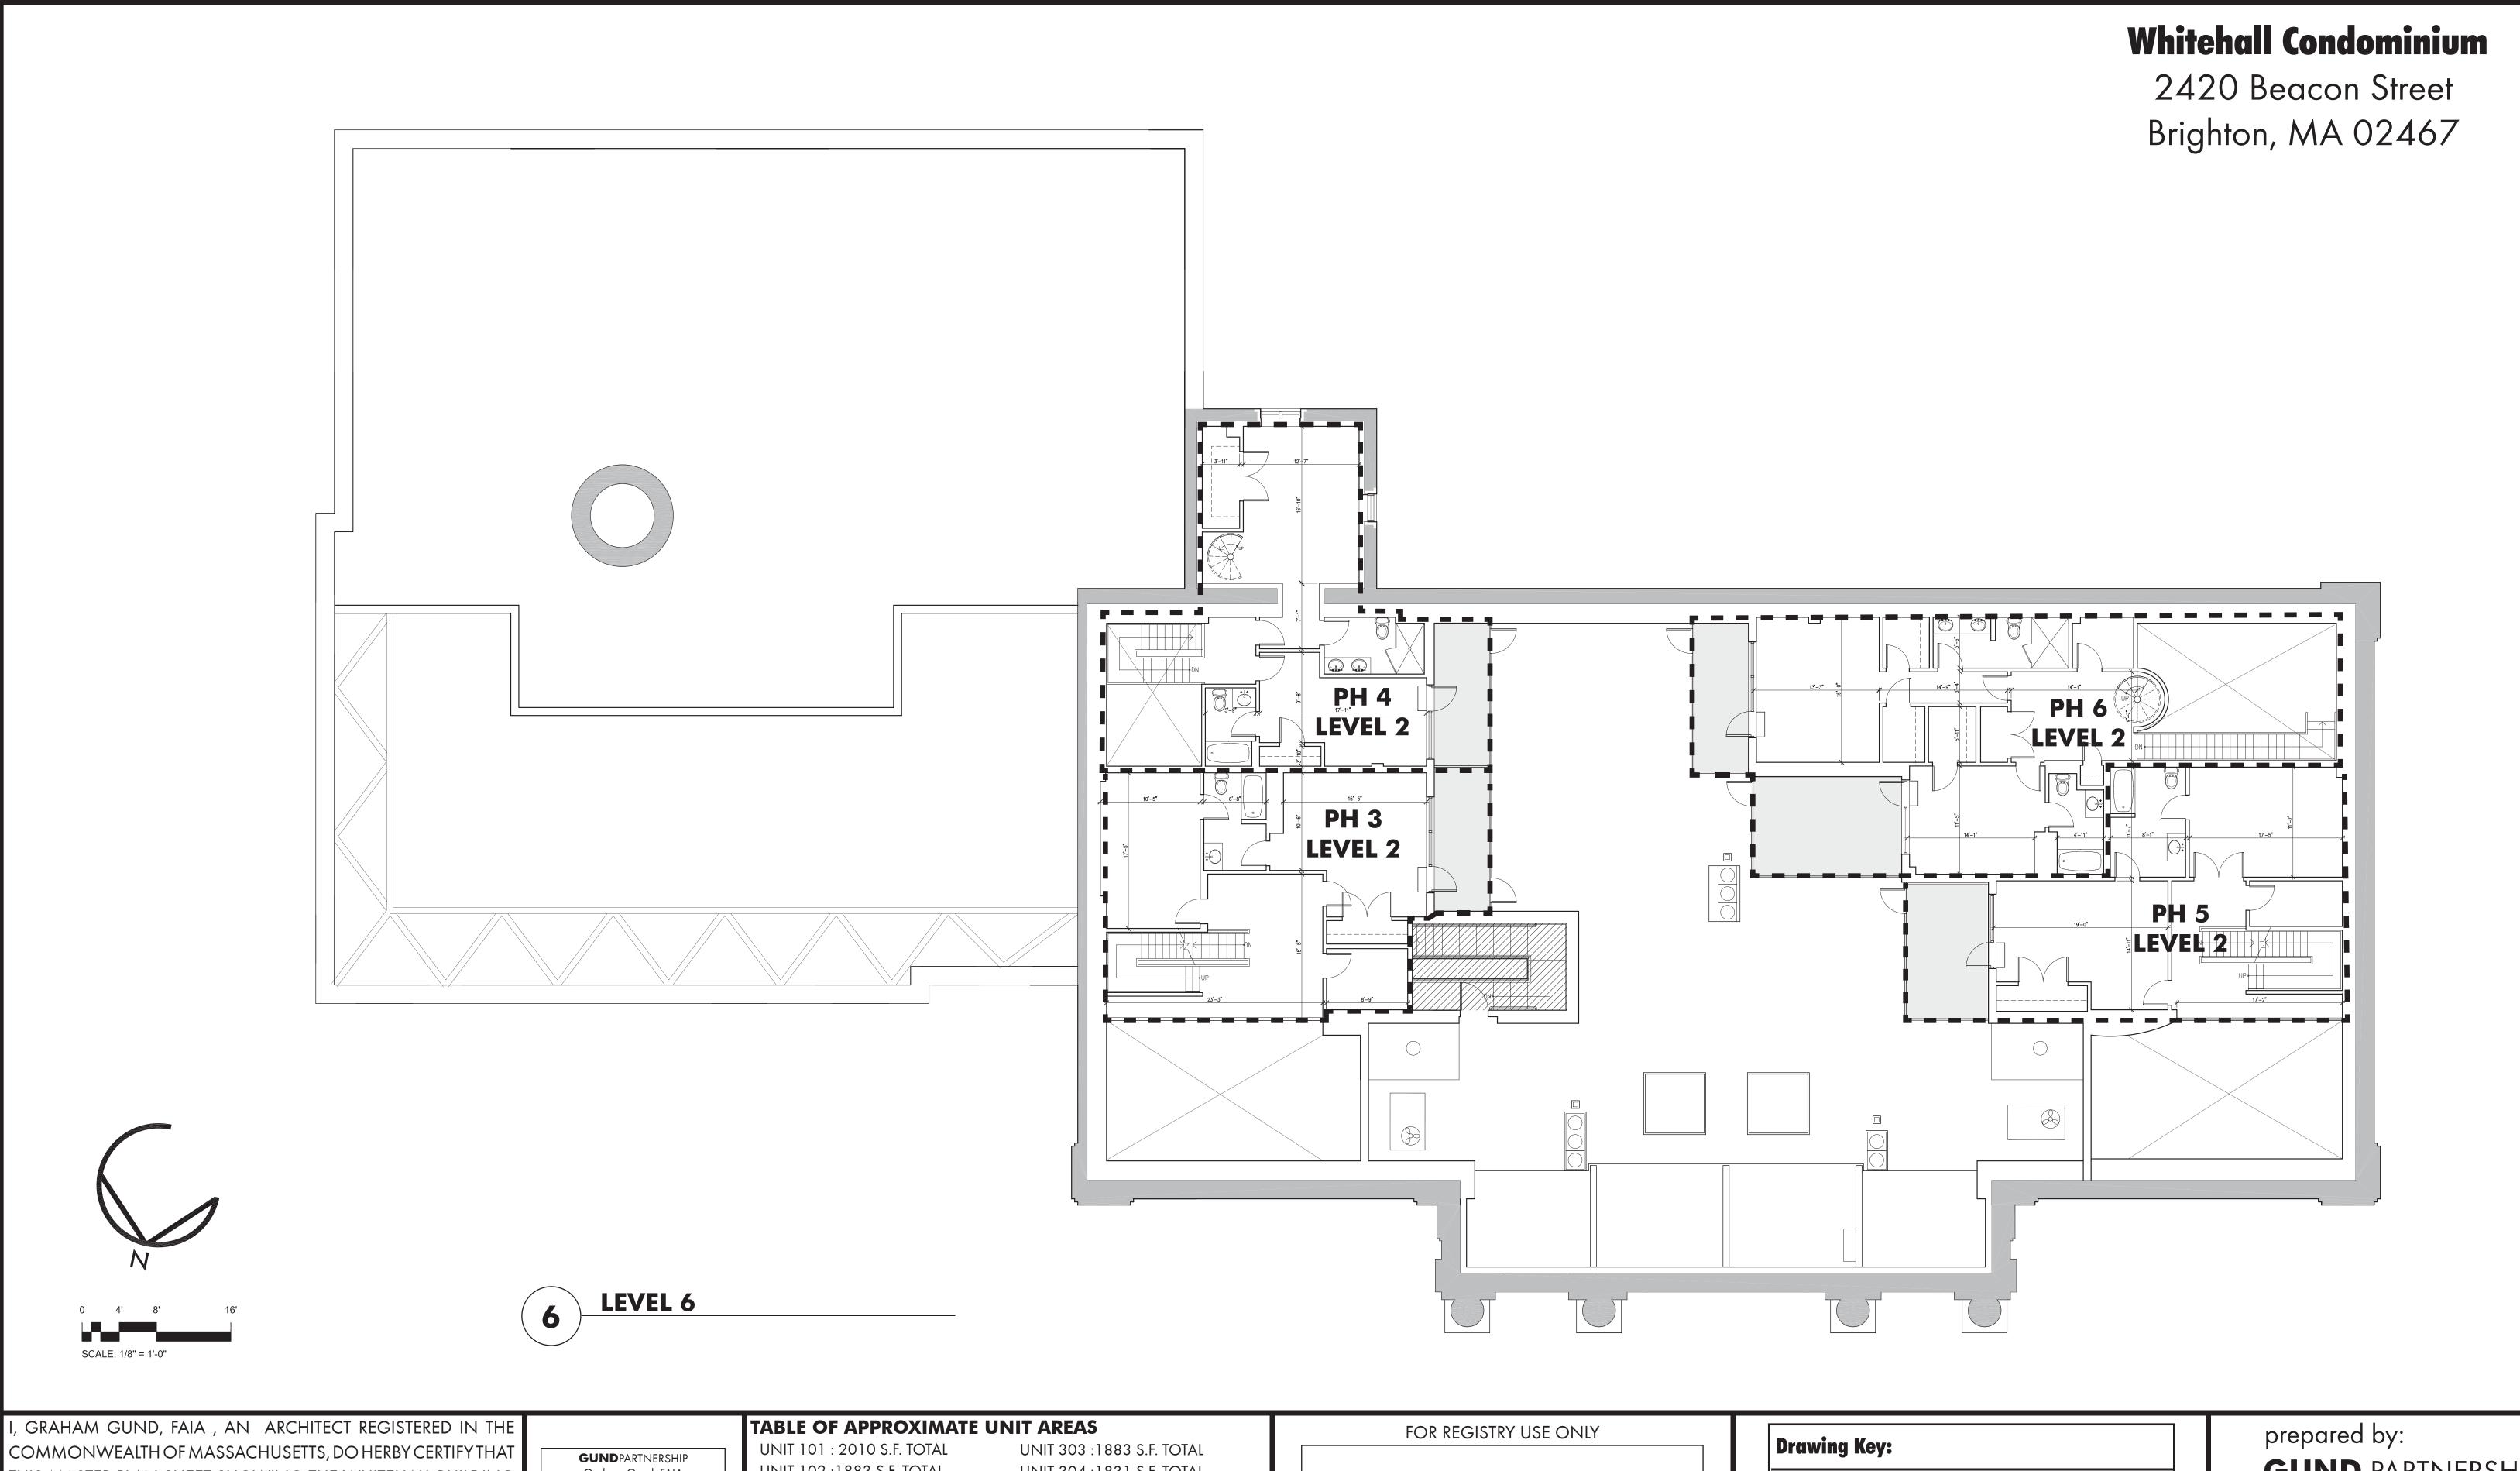

THIS MASTER PLAN SHEET SHOWING THE WHITEHALL BUILDING IN THE CITY OF BRIGHTON , SUFFOLK COUNTY, MASSACHUSETTS, DEPICTS THE LAYOUT OF THE BUILDING AND THE UNITS, UNIT NUMBERS, UNIT LOCATION, APPROXIMATE DIMENSIONS AND MAIN ENTRANCES AND THE PUBLIC WAY TO WHICH THE UNITS HAVE ACCESS, AS-BUILT AS OF NOVEMBER 29, 2006, I ALSO CERTIFY THAT THE PLAN WAS PREPARED IN ACCORDANCE WITH THE RULES AND REGULATIONS OF THE REGISTRY OF DEEDS.

Graham Gund, FAIA Registered Architect # 3720


UNIT 102 :1883 S.F. TOTAL UNIT 304:1831 S.F. TOTAL UNIT 201 : 2044 S.F. TOTAL UNIT 401 :1895 S.F. TOTAL UNIT 202 : 2118 S.F. TOTAL UNIT 402 :1900 S.F. TOTAL UNIT 203 : 2647 S.F. TOTAL UNIT PH 1 : 2094 S.F. TOTAL UNIT 204 :1100 S.F. TOTAL UNIT PH 2 : 2083 S.F. TOTAL UNIT 205 :1093 S.F. TOTAL UNIT PH 3 :1957 S.F. TOTAL UNIT 206 : 2346 S.F. TOTAL UNIT PH 4 : 2329 S.F. TOTAL UNIT PH 5 :1884 S.F. TOTAL UNIT 301 : 2243 S.F. TOTAL

UNIT PH 6 :1730 S.F. TOTAL

UNIT 302 :1895 S.F. TOTAL

Line of Limit of Ownership: Common Area: Unit Entrance: Exterior Limited Common Element Area:

GUND PARTNERSHIP 47 THORNDIKE STREET CAMBRIDGE, MA 02141 (617)250-6800 GUNDPARTNERSHIP

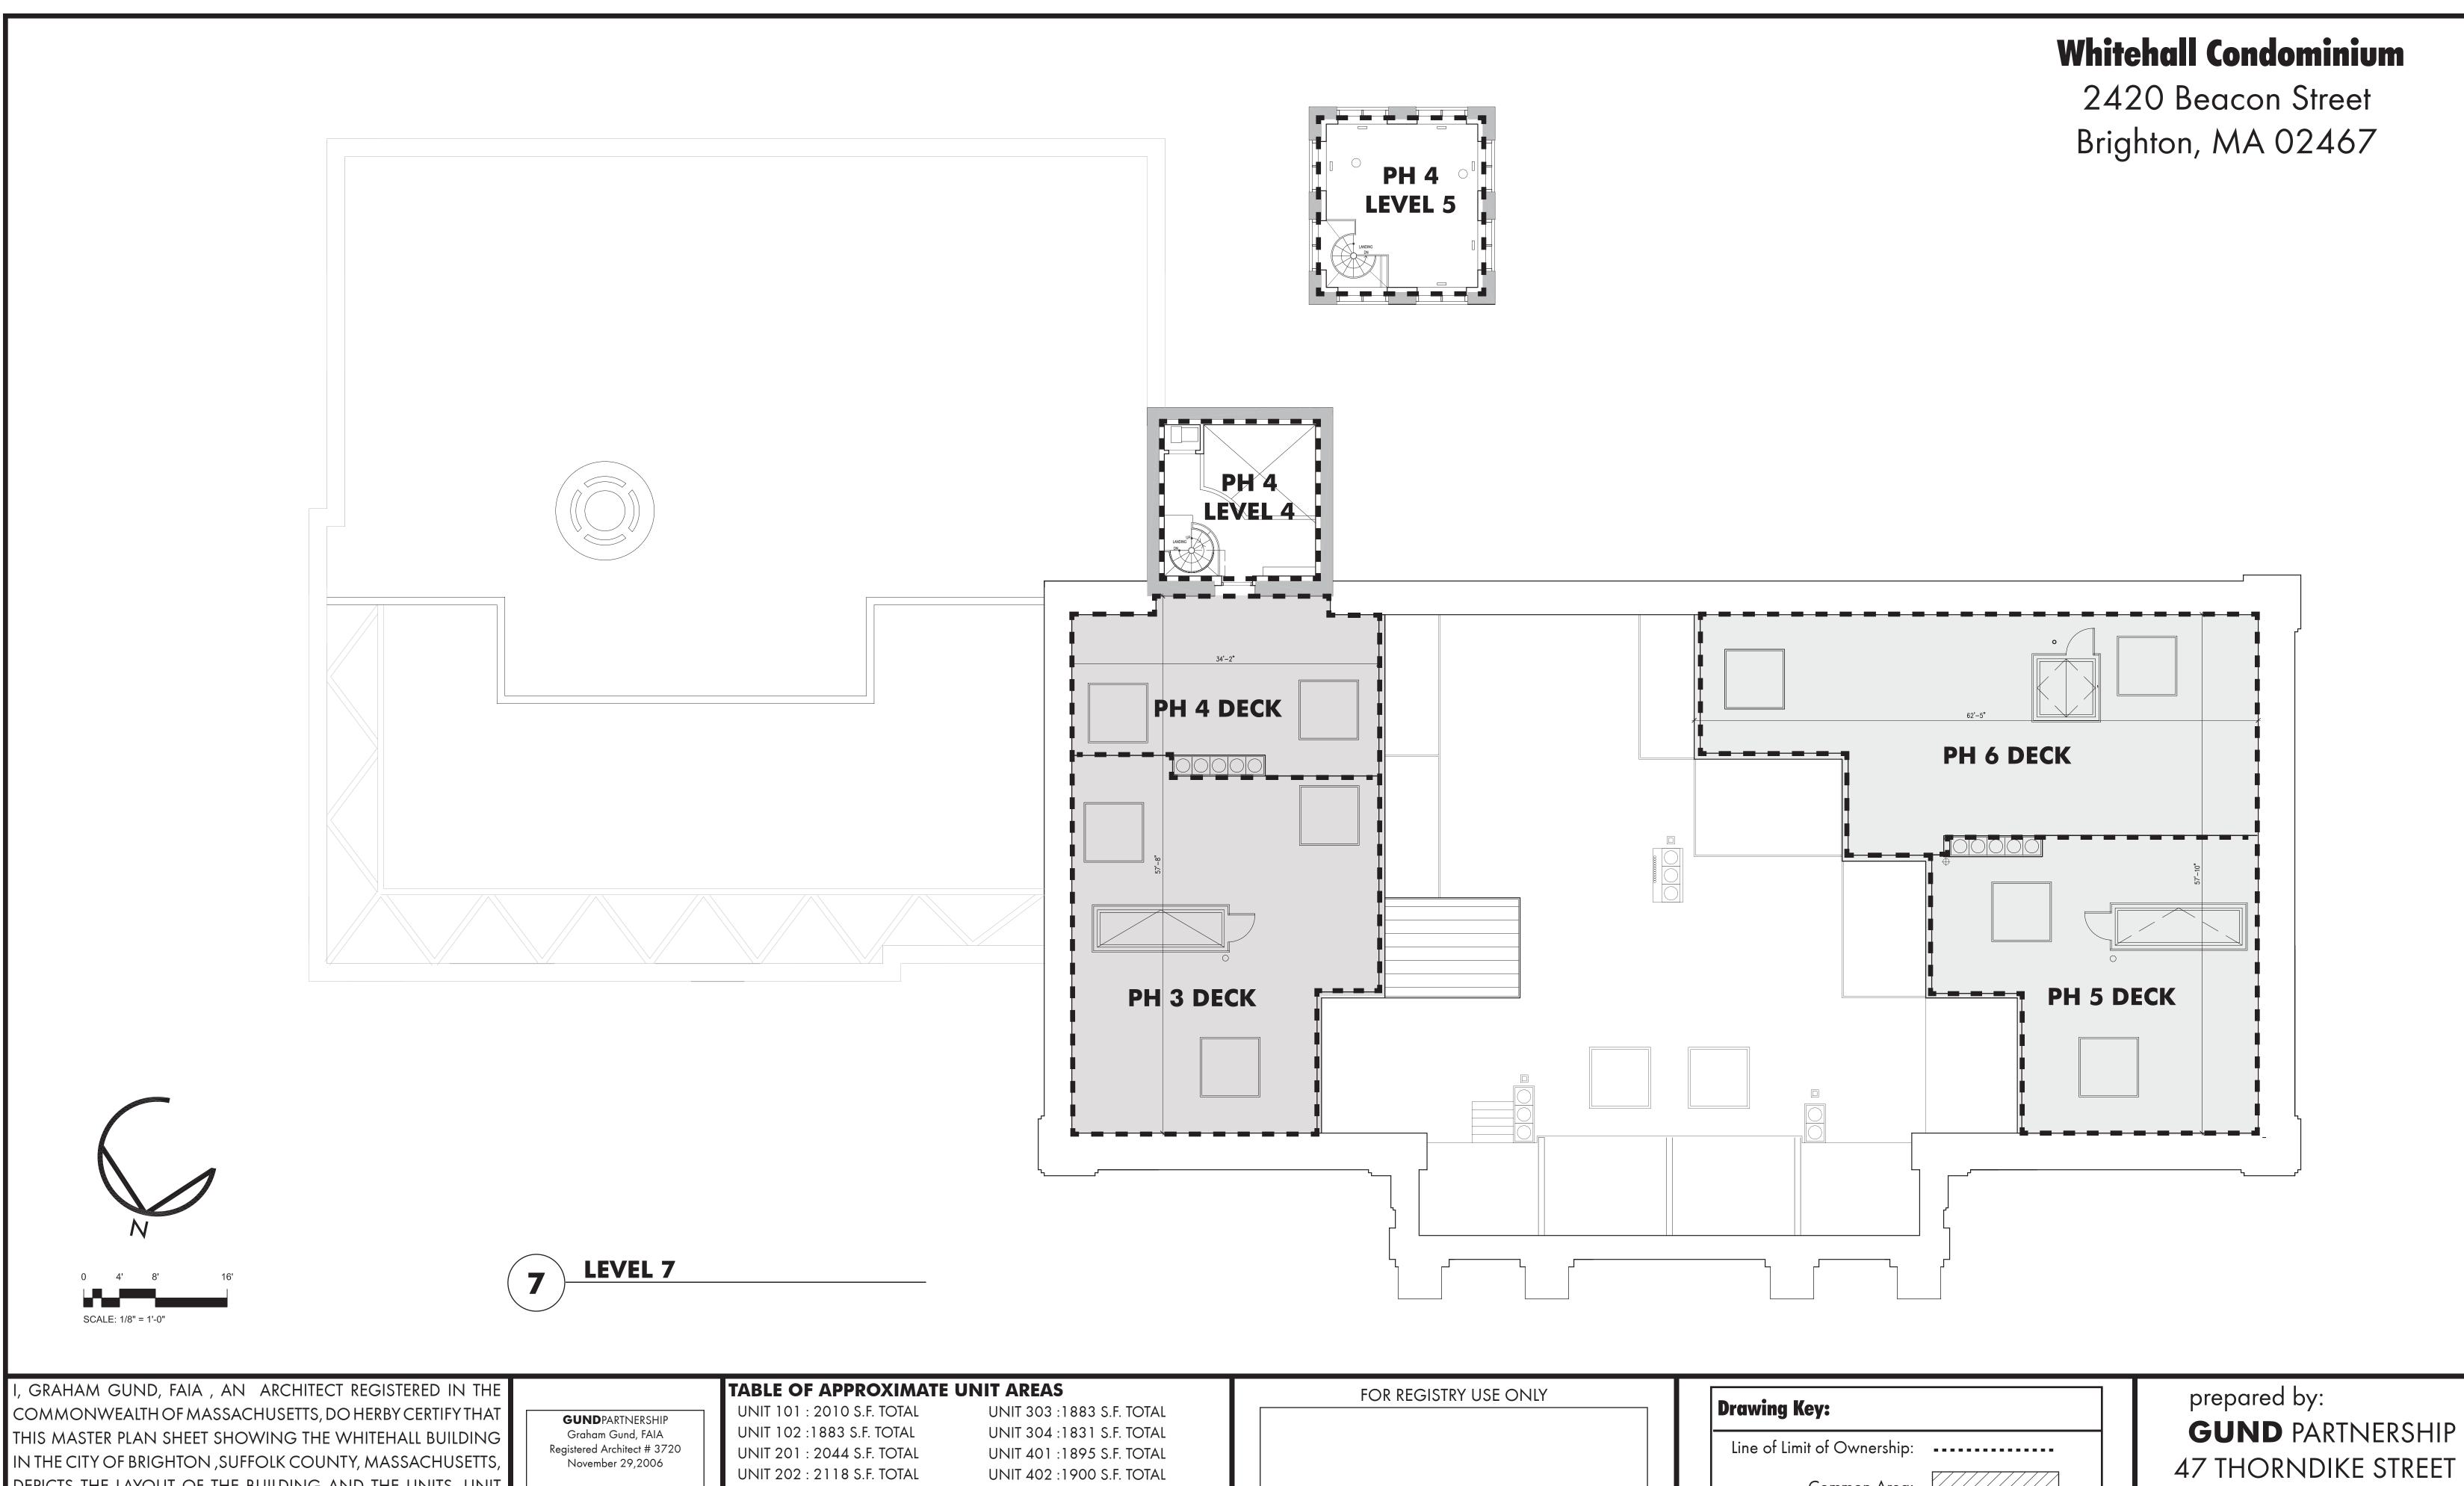

COMMONWEALTH OF MASSACHUSETTS, DO HERBY CERTIFY THAT THIS MASTER PLAN SHEET SHOWING THE WHITEHALL BUILDING IN THE CITY OF BRIGHTON, SUFFOLK COUNTY, MASSACHUSETTS, DEPICTS THE LAYOUT OF THE BUILDING AND THE UNITS, UNIT NUMBERS, UNIT LOCATION, APPROXIMATE DIMENSIONS AND MAIN ENTRANCES AND THE PUBLIC WAY TO WHICH THE UNITS HAVE ACCESS, AS-BUILT AS OF NOVEMBER 29, 2006, I ALSO CERTIFY THAT THE PLAN WAS PREPARED IN ACCORDANCE WITH THE RULES AND REGULATIONS OF THE REGISTRY OF DEEDS.

UNIT 101 : 2010 S.F. TOTAL
UNIT 102 :1883 S.F. TOTAL
UNIT 201 : 2044 S.F. TOTAL
UNIT 202 : 2118 S.F. TOTAL
UNIT 203 : 2647 S.F. TOTAL
UNIT 204 :1100 S.F. TOTAL
UNIT 205 :1093 S.F. TOTAL
UNIT 206 : 2346 S.F. TOTAL
UNIT 303 :1883 S.F. TOTAL
UNIT 304 :1831 S.F. TOTAL
UNIT 401 :1895 S.F. TOTAL
UNIT 402 :1900 S.F. TOTAL
UNIT PH 1 : 2094 S.F. TOTAL
UNIT PH 2 : 2083 S.F. TOTAL
UNIT PH 3 :1957 S.F. TOTAL
UNIT PH 4 : 2329 S.F. TOTAL
UNIT PH 5 :1884 S.F. TOTAL

UNIT PH 6 : 1730 S.F. TOTAL

UNIT 302 :1895 S.F. TOTAL

FOR REGISTRY USE ONLY

Line of Limit of Ownership:

Common Area:

Unit Entrance:

Exterior Limited Common
Element Area:

GUND PARTNERSHIP

47 THORNDIKE STREET

CAMBRIDGE, MA 02141

(617)250-6800

GUNDPARTNERSHIP